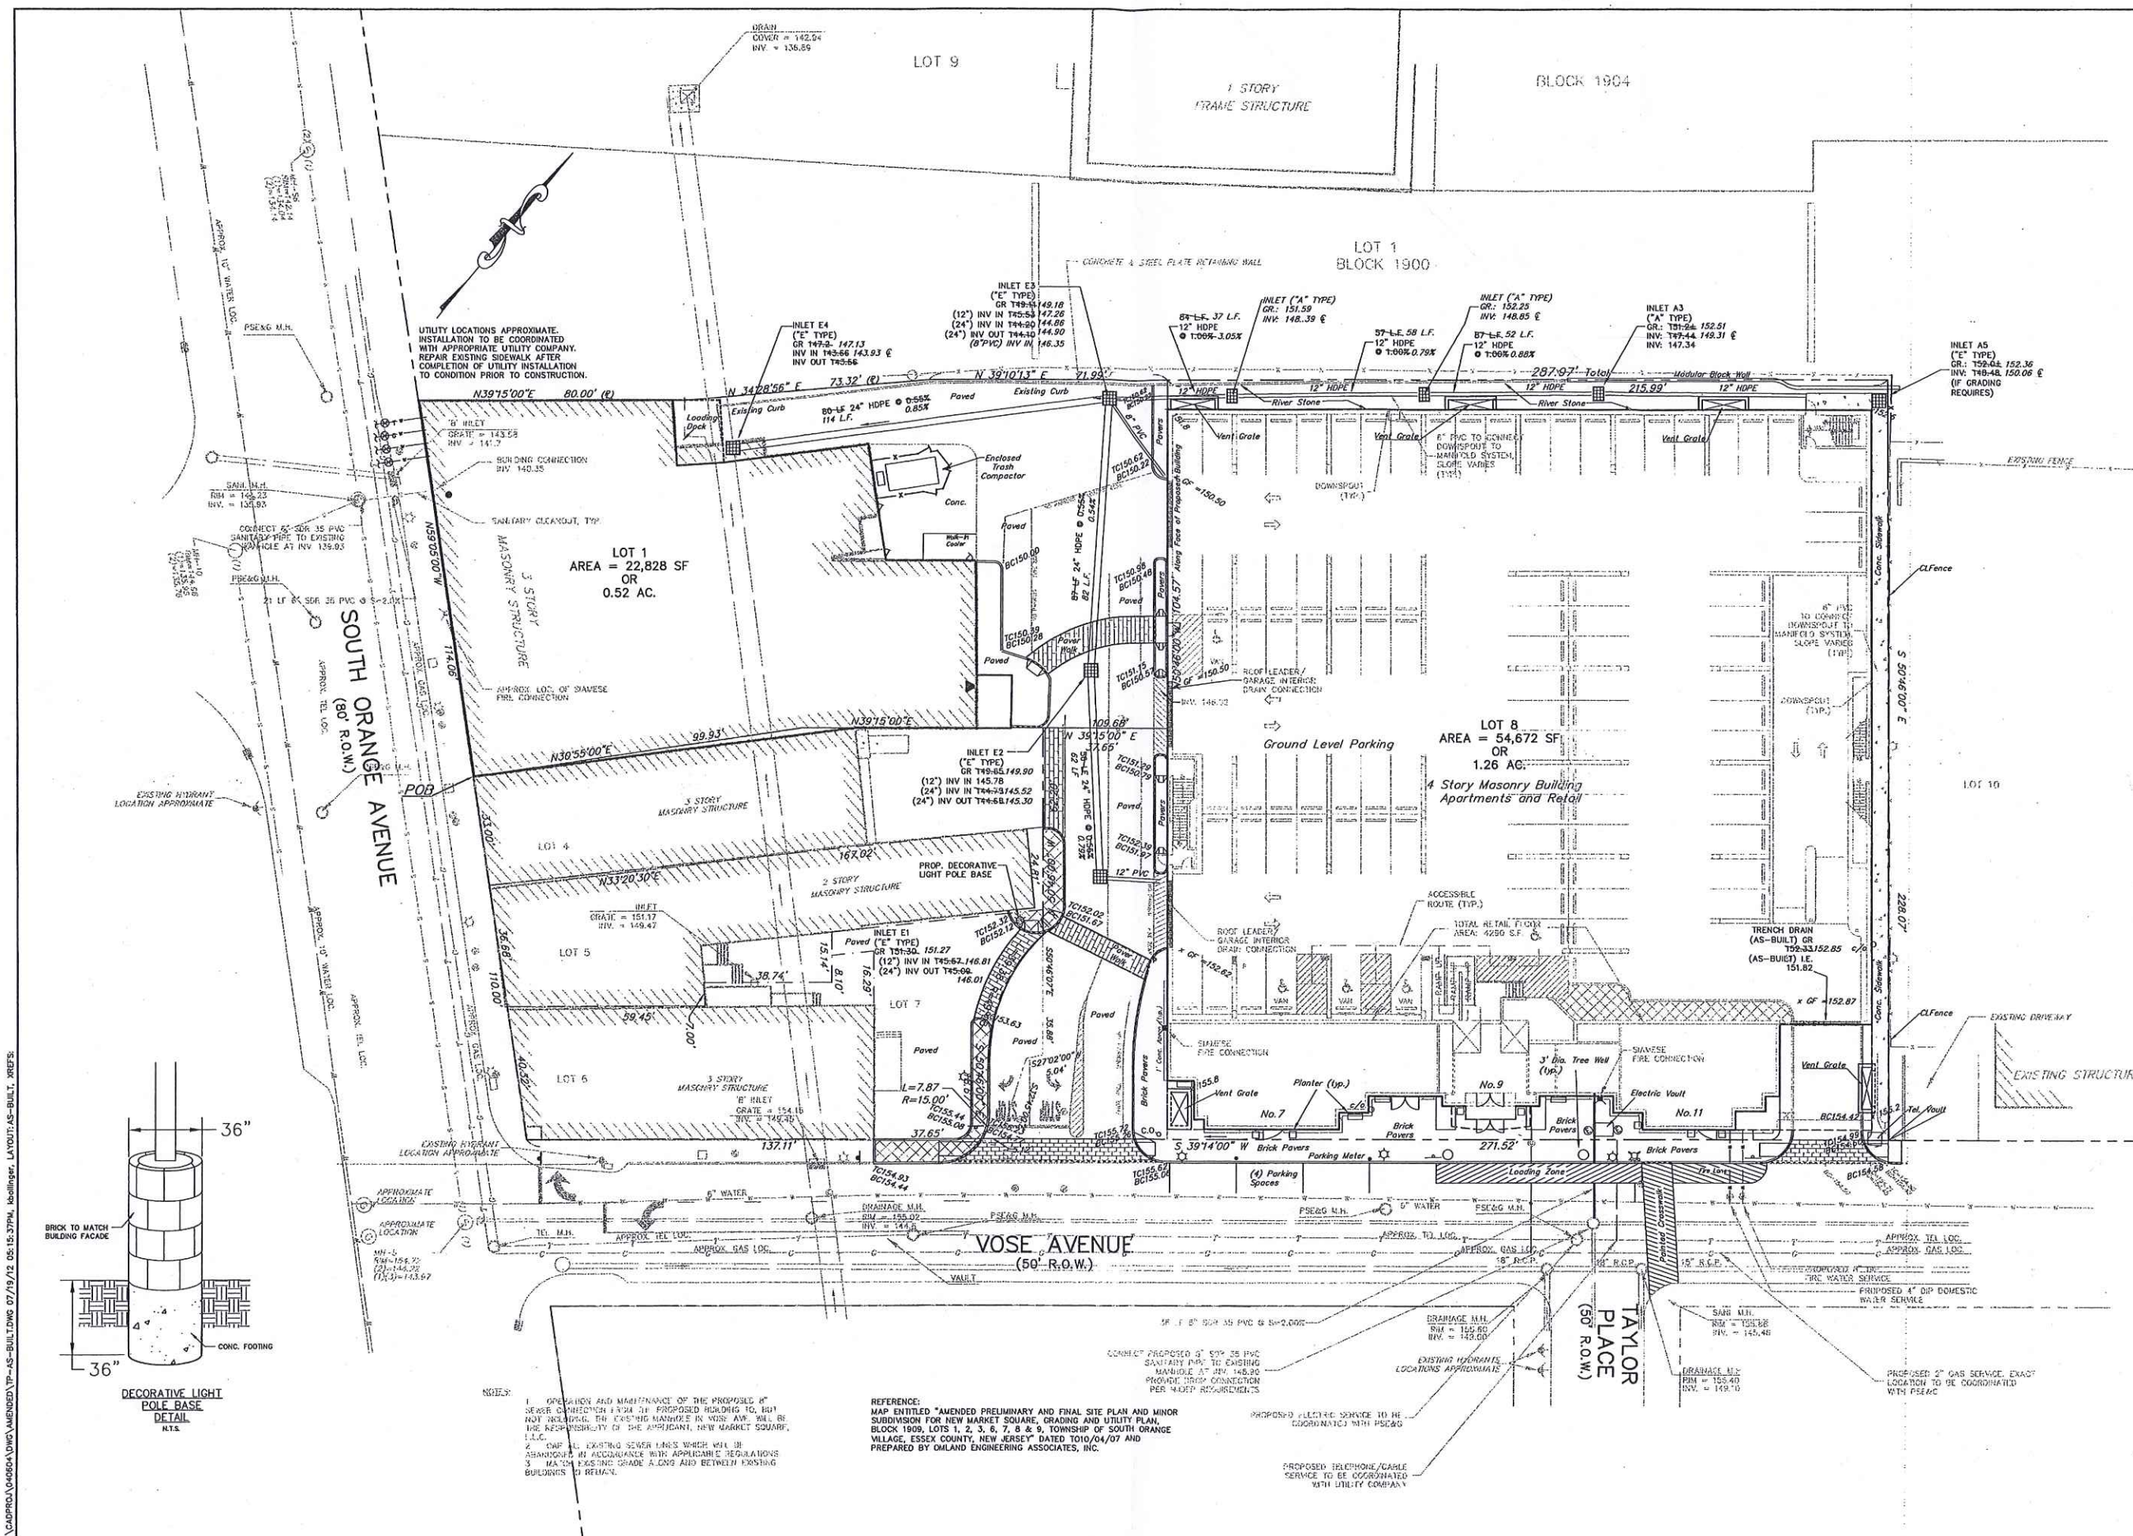

NOTES:

1. OPERATION AND MAINTENANCE OF THE PROPOSED 8" SEWER CONNECTION FROM THE PROPOSED BUILDING TO, BUT NOT INCLUDING, THE EXISTING MANHOLE IN VOSE AVE. WILL BE THE RESPONSIBILITY OF THE APPLICANT, NEW MARKET SQUARE, L.L.C.
2. ONE (1) EXISTING SEWER LINES WHICH WILL BE ABANDONED IN ACCORDANCE WITH APPLICABLE REGULATIONS
3. MATCH EXISTING GRADE ALONG AND BETWEEN EXISTING BUILDINGS TO REMAIN.

REFERENCE:
MAP ENTITLED "AMENDED PRELIMINARY AND FINAL SITE PLAN AND MINOR SUBDIVISION FOR NEW MARKET SQUARE, GRADING AND UTILITY PLAN, BLOCK 1909, LOTS 1, 2, 3, 6, 7, 8 & 9, TOWNSHIP OF SOUTH ORANGE VILLAGE, ESSEX COUNTY, NEW JERSEY" DATED 10/04/07 AND PREPARED BY OMLAND ENGINEERING ASSOCIATES, INC.

REVISIONS		
9		
8		
7		
6		
5		
4		
3		
2	Update Asbuilt Survey Additional locations	7/19/12
1	Update Asbuilt Survey Additional locations	10/28/11

DATE: 4/5/10
PROJ.: 040604
SCALE: 1" = 20'
CHKD.: AO

OMLAND
ENGINEERING ASSOCIATES, INC.
54 Horsehill Road
Cedar Knolls, New Jersey 07927
Phone: 973-359-8400
FAX: 973-359-8455
E-mail: omland@omland.com
NJ Certificate of Authorization No. 24GA28043700
STANLEY T. OMLAND, P.L.S. Professional Engineer, Lic. 30086
DAVID B. BIDDIX, N.J. Professional Land Surveyor, Lic. 27283

NEW MARKET SQUARE AS-BUILT PLAN

BLOCK 1909 LOTS 1, 2, 3, 7, 8, & 9

TOWNSHIP OF SOUTH ORANGE VILLAGE, ESSEX COUNTY, NEW JERSEY

SHEET No. 1 OF 1

RECEIVED APR 16 2013

P:\CADPROJ\040604\DWG\AMENDED\TP-AS-BUILT.DWG 07/19/12 05:15:37PM, kcollinger, LAYOUT: AS-BUILT, XREF'S: